


No. 56  
Princes Gate

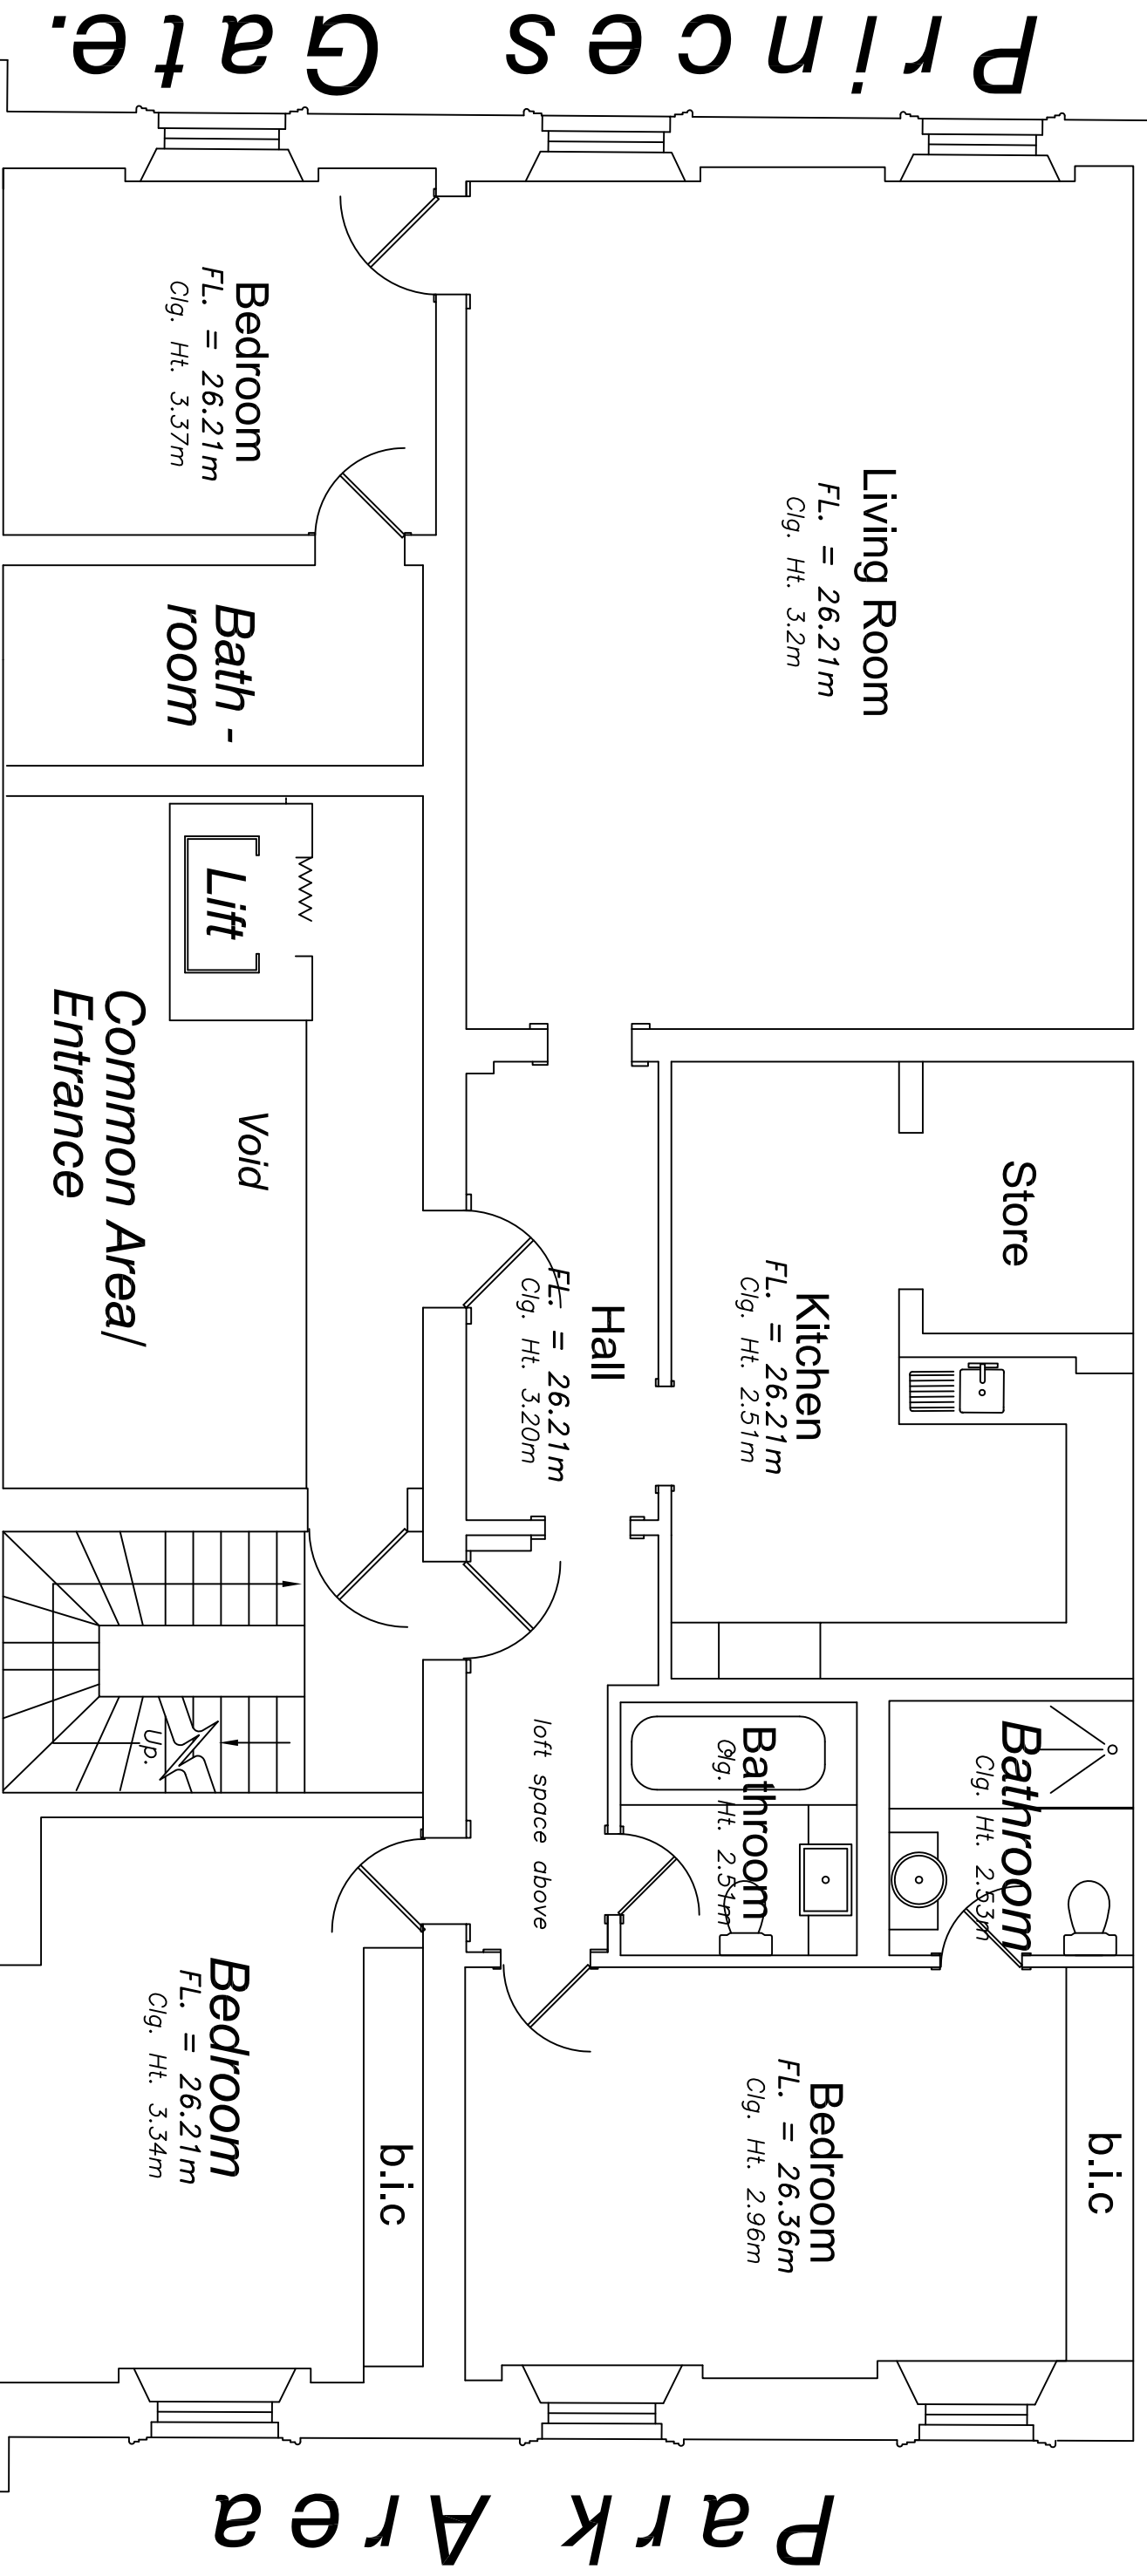

No. 58  
Princes Gate

# Flat D\_3rd Floor Plan

As built

22.10.2012

Park Area