



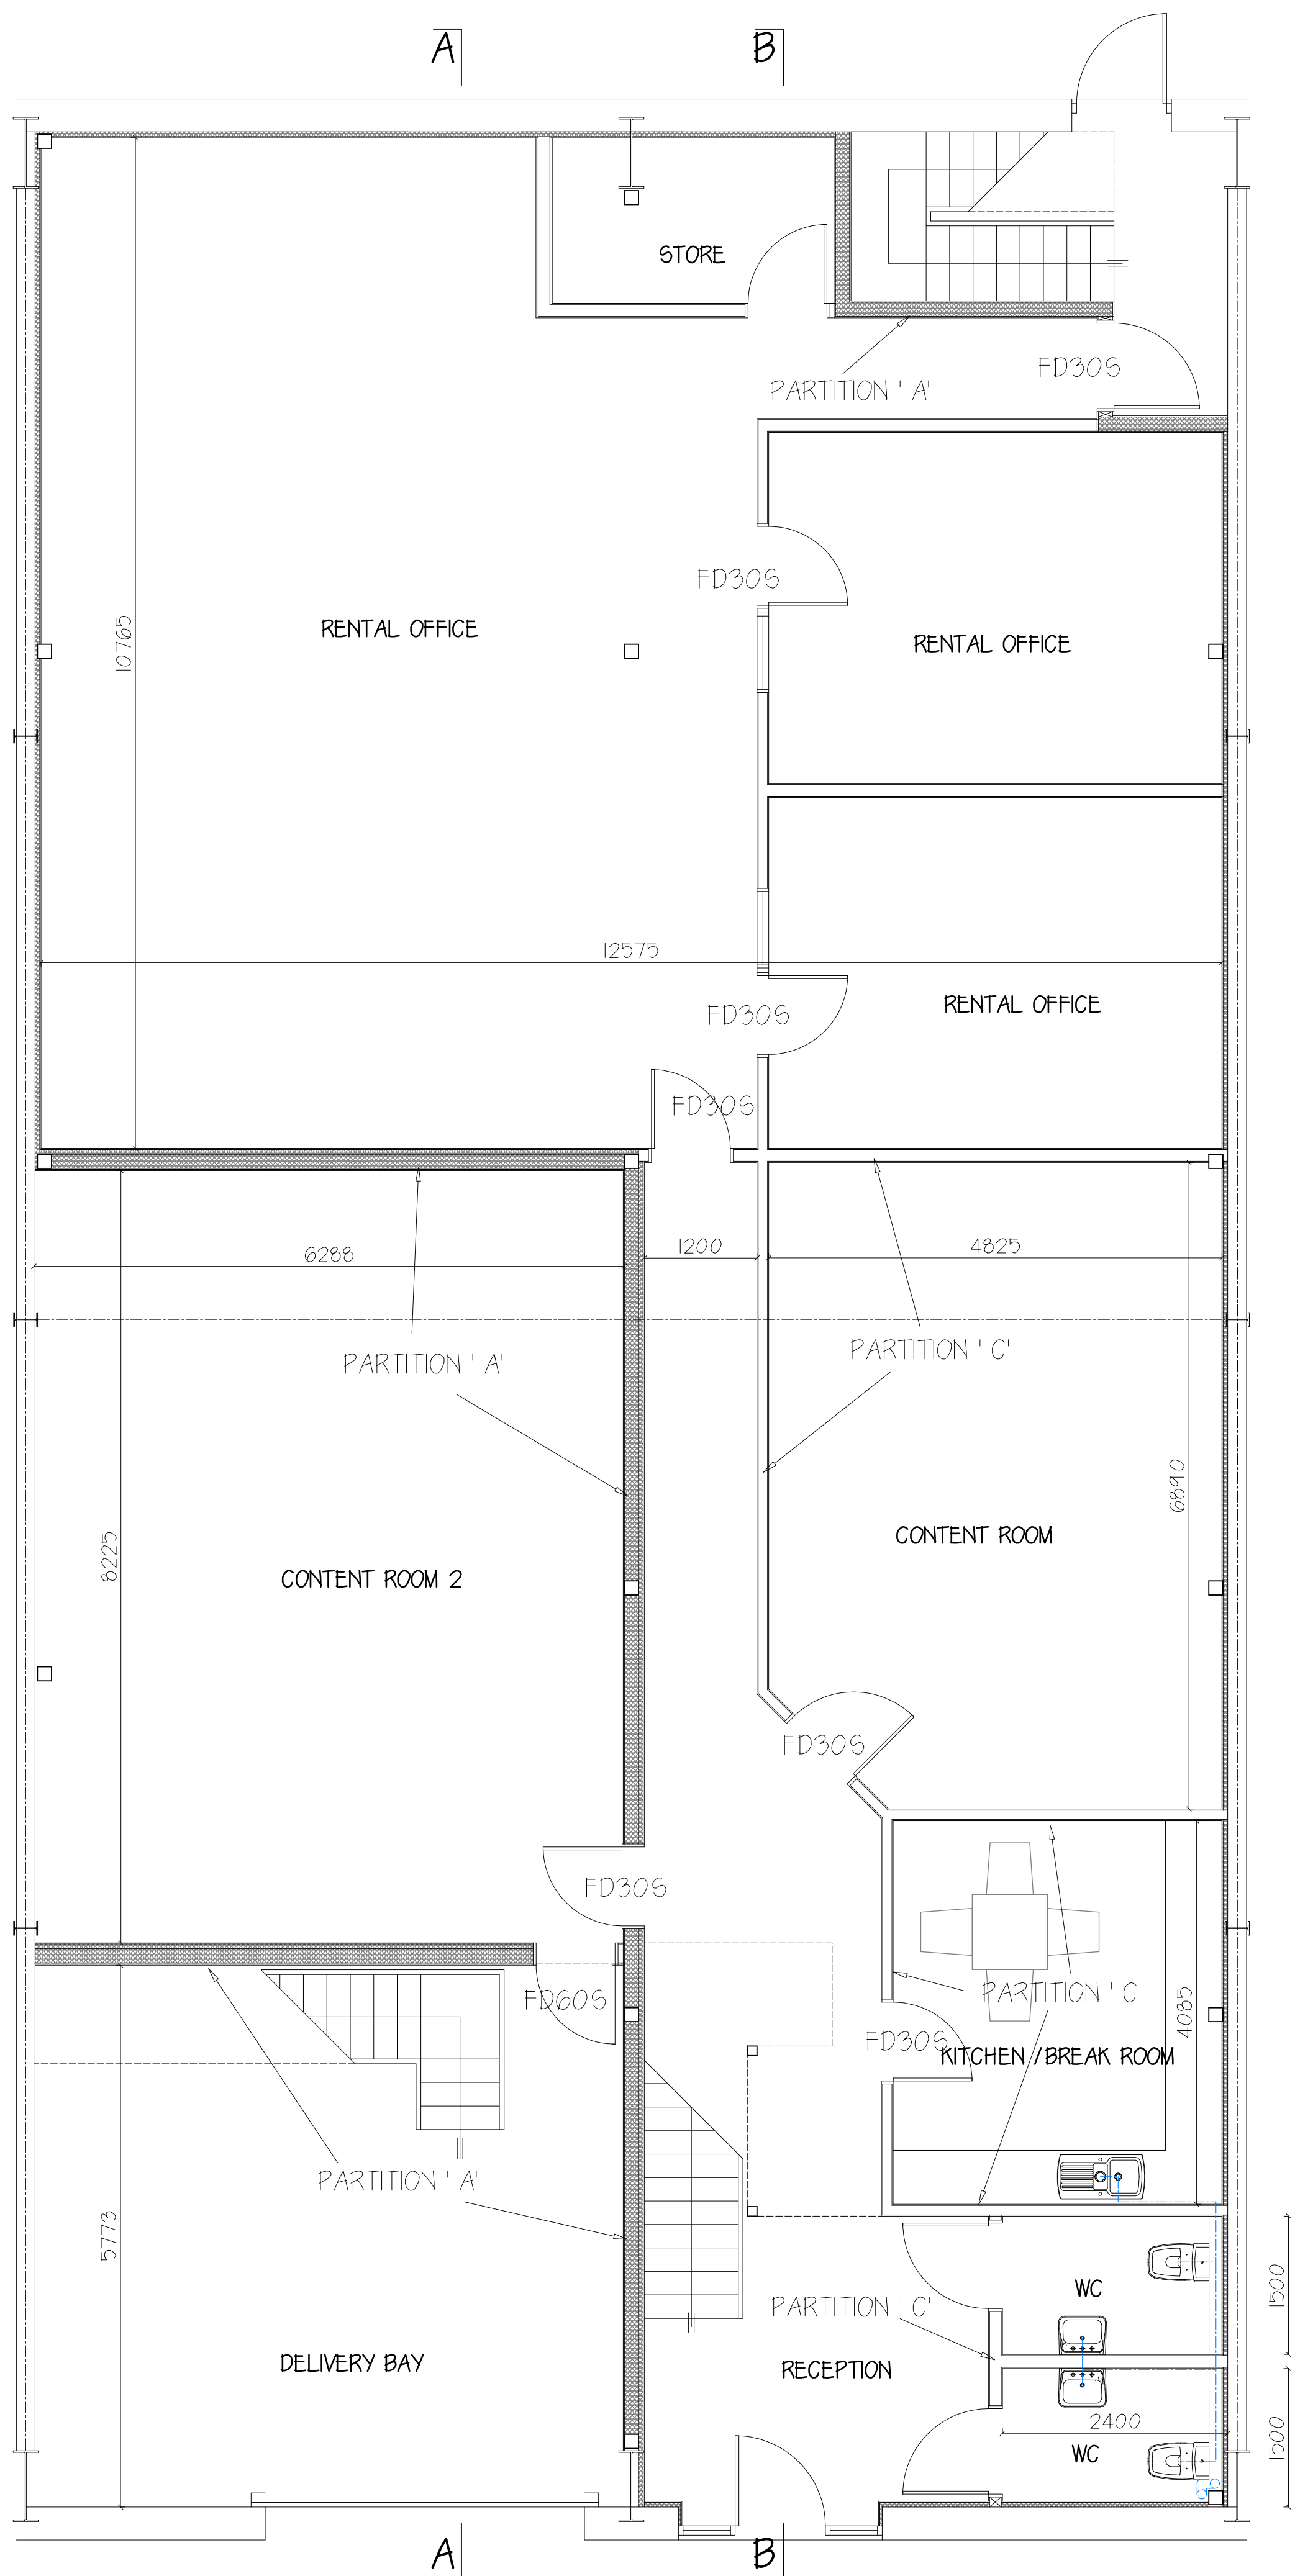

GROUND PROPOSED

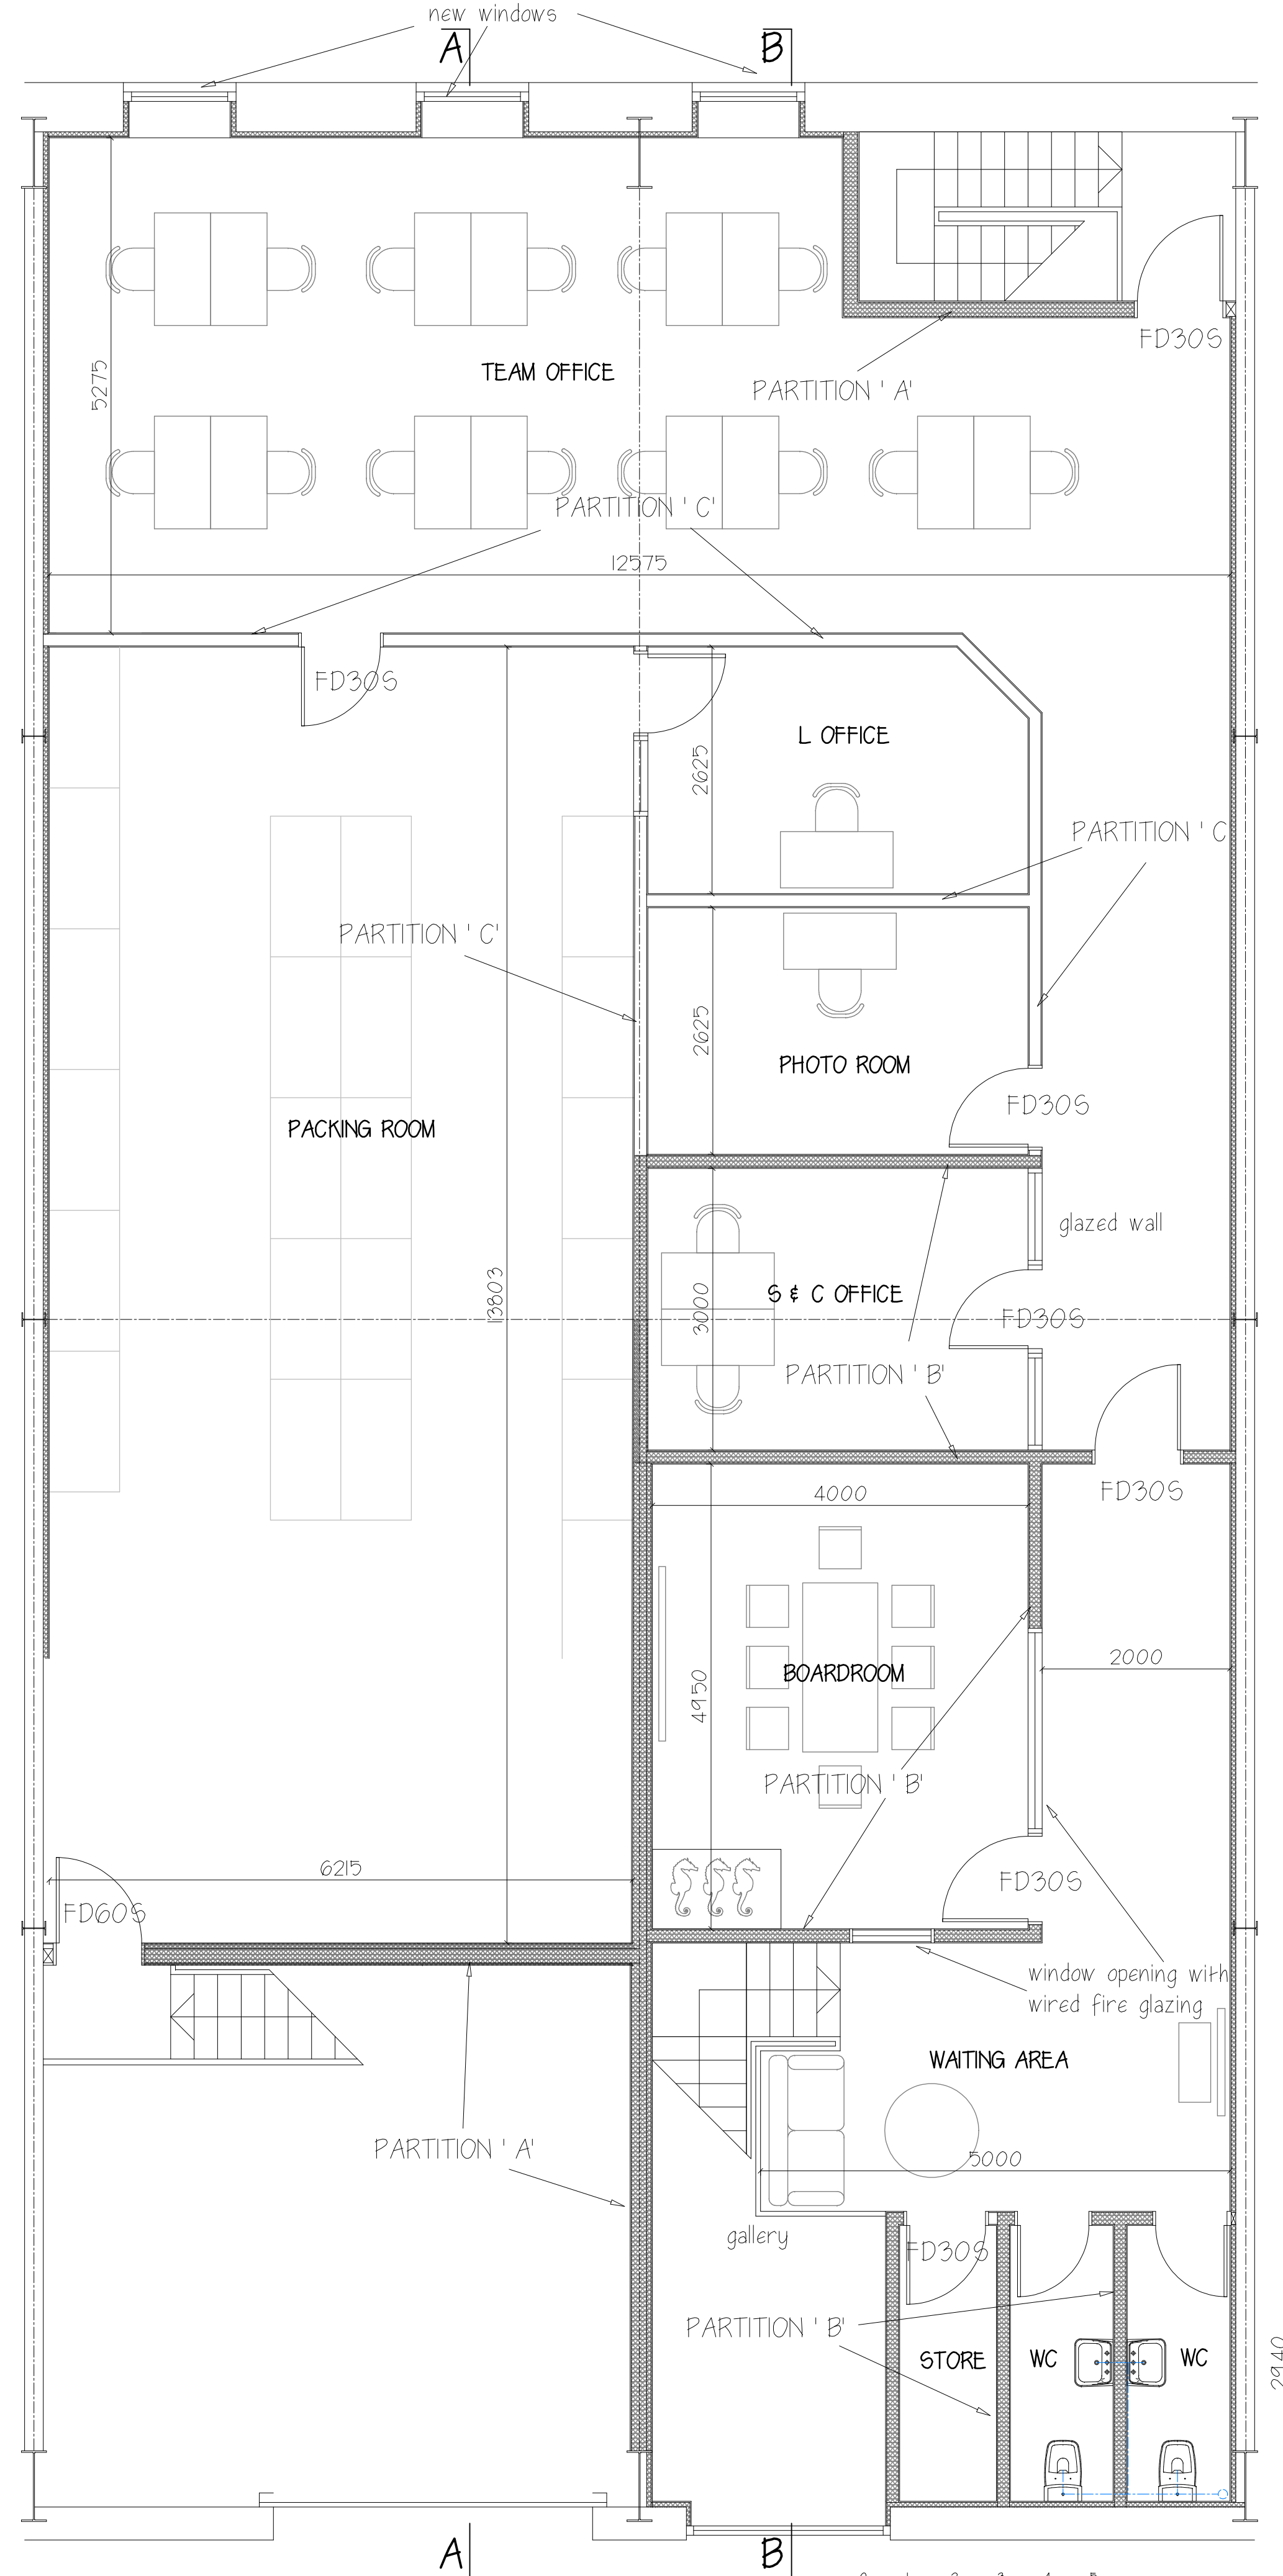

FIRST PROPOSED

DO NOT SCALE EXCEPT FOR PLANNING APPLICATION PURPOSES. USE FIGURED DIMENSIONS. ANY DISCREPANCIES ARE TO BE REPORTED TO THIS OFFICE PRIOR TO THE CONTINUANCE OF WORKS. THIS DRAWING IS THE COPYRIGHT OF MALCOLM B J PERCY, BUILDING DESIGN & PLANNING CONSULTANCY, & MUST NOT BE REPRODUCED IN ANY FORMAT WITHOUT THE PRIOR WRITTEN AGREEMENT OF THIS OFFICE.

A - June 2023, General layout revisions to show as built situation

Malcolm B. J. Percy, 5, Newark Place, Henhull, Nantwich, Cheshire, CW5 6XY.
E-mail : malcolmpercy@hotmail.com
Mobile : 07802 663325

BUILDING DESIGN
AND PLANNING

Consultancy

PROJECT CONVERSION OF INDUSTRIAL UNIT INTO OFFICES,
CHARNOCK POINT, CHARNOCK ROAD,
LIVERPOOL, L9 7ET.

CLIENT SAY IT WITH.

TITLE PROPOSED FLOOR PLANS

DATE	SCALE	DRAWN BY	DRAWING NO.	REVISION
April 2024	1:50 @ A1	mbjp	2331.02	A